

May 31, 2011

Mayor Dawn Zimmer
94 Washington Street
Hoboken, NJ 07030

**Re: Sovereign at Shipyard – Response to Boswell Underwater Engineering Draft Report
Hoboken, NJ**

Dear Mayor Zimmer,

We are writing this letter in response to the draft report written by Boswell Underwater Engineering (Boswell) on the underwater survey they performed of the Hoboken Privately-Owned Waterfront Structures (dated March 2011). Specifically, we are responding to the comments made regarding The Sovereign at Shipyard building (reference section 6 of the report).

Section 6.2 “Inspection Findings”

This section states that no apparent bulkhead to retain the inland fill was visible and that the tidal waters have allowed fill to escape and settle below the structural slab of the Sovereign building.

No bulkhead wall was encountered at the north-east corner of the building during the inspection because it is located on the land side of the wood platform supporting the existing sea wall. A new bulkhead wall was installed in the form of corrugated steel sheet piles which were driven inland of the existing wood platform to retain the soil beneath the remainder of the building (reference plans on S-100 and S-300 and details 6, 7A, and 7B on drawing S-100, attached).

Pictures 6.11 through 6.15 in Boswell’s report depict settlement of the fill above the existing platform (below the building structural slab) as well as rigid insulation delaminating from the underside of the slab. The condition revealed in these photographs does not, however, raise any structural concerns. The ground floor slab of the Sovereign building is a reinforced concrete slab which was designed to span between pile caps (reference drawings S-101 and S-301, attached). The insulation served simply as formwork to support the wet concrete when the slab was poured. Structurally this slab behaves just as the upper floor slabs do in as much as the formwork is only required until the concrete has cured sufficiently to reach adequate strength to span between permanent supports.

Section 6.3 “Steel Pipe Piles”

This section states that some loss of protective coating and minor to moderate corrosion was found at the steel pipe piles within the tidal zone. Based on testing conducted, the writer estimates an average section loss of the pile cross section of approximately 14%.

The building structure was designed to be supported on 100 ton piles. The piles supporting the portion of the building over the river were reinforced so as not to require the steel casing (pipe) in order to carry the building loads (reference Foundation Notes on drawing S-001 and section 13 on

drawing S-002, attached). The piles in this area (north-east corner of the building) were designed in anticipation of the section of the pipe above the river mud line corroding away over time, which is consistent with the conditions depicted in photographs 6.11 and 6.12 of Boswell's report. The concrete filled pipes were reinforced with epoxy coated reinforcing steel so as to be maintenance free in the long term.

Section 6.4 "Concrete Pile Caps, Beams and Deck Planks"

This section states that the condition of the pre-cast beams and deck planks visible were in good condition with no deterioration noted.

Section 6.5 "Recommendations"

This section includes two recommendations regarding actions and repairs.

The writer recommends that an investigation and engineering analysis be performed for the area inland of the high-level platform to determine the impact of the fill loss from beneath the building slab and if repairs are required. As we explained above (see the response to Section 6.2), the fill is not structural and therefore its loss does not pose any structural issues. Additionally, no structural repairs are required.


The writer also recommends that a routine procedure be established where the steel pipe piles are cleaned and a protective coating is applied to the sections of the piles within the tidal zone to prevent further corrosion. As we explained above (see the response to Section 6.3), the steel casing of these piles above the mud line are nonstructural and therefore the corrosion noted, as well as potential further corrosion, does not diminish the load carrying capacity of the piles in any way.

In summary, the conditions of and surrounding the structural elements below the Sovereign building slab as stated in the Boswell report signify no cause for concern and no remedial actions need be taken. Periodic inspection as part of routine building maintenance is always advisable.


We trust that this letter serves to alleviate any concern of conditions exposed in Boswell's report, however, please feel free to contact us should you have any additional questions.

Sincerely,
GACE Consulting Engineers PC



Alyson Sikorski, PE
Associate

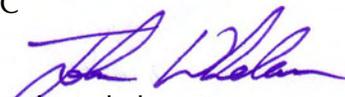
John Whelan, PE
Principal


CC: D. Barry (TAC)
M. Barry (TAC)
J. Wuestneck (TAC)

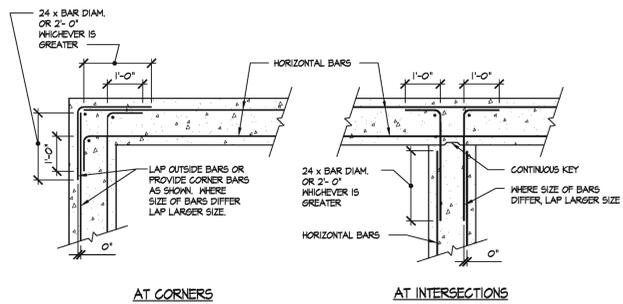


TYPICAL PLAN OF HORIZONTAL REINFORCING FOR CONCRETE WALLS AND GRADE BEAMS
 1/2" = 1'-0"

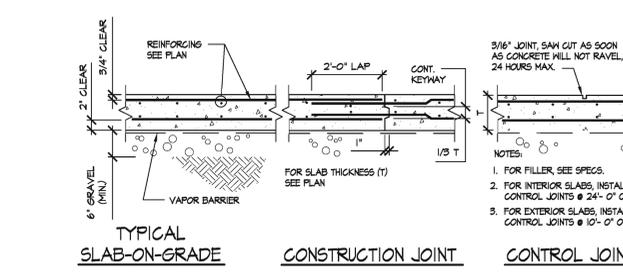


TYPICAL FRAMED SLAB-ON-GRADE DETAILS
 3/4" = 1'-0"

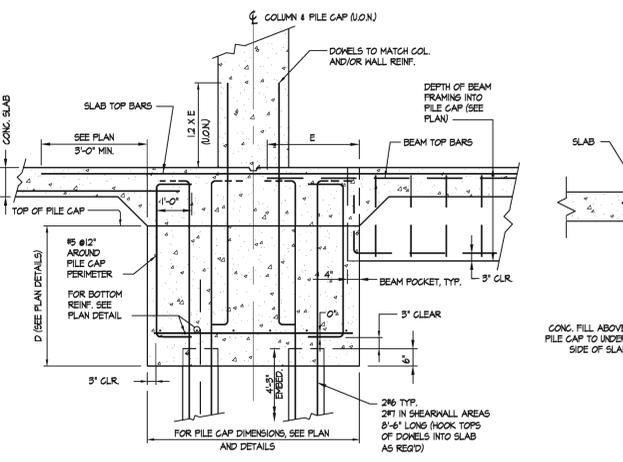


TYPICAL PILE CAP DETAIL
 1/2" = 1'-0"
 NOTE: E = EMBEDMENT LENGTH PER ACI-318.

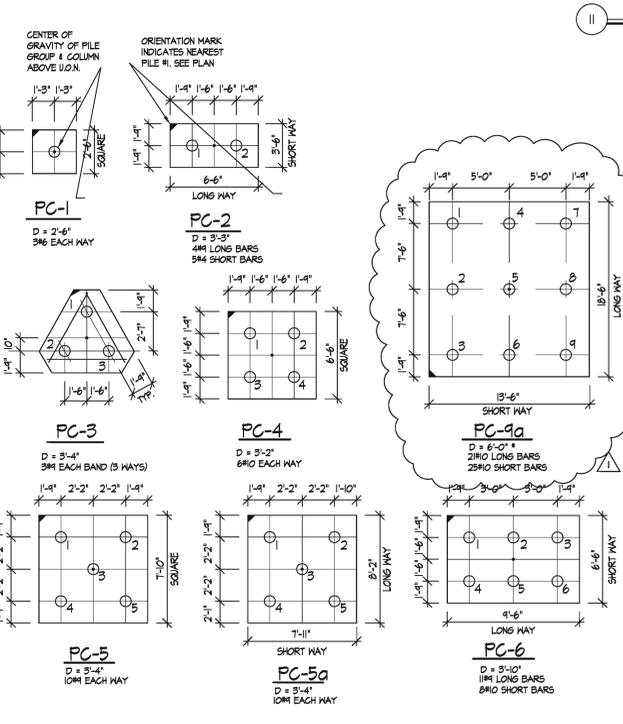


PILE CAP DETAILS
 NOTES:
 1. * INDICATES THAT NO 180 DEGREE HOOKS AT EACH END OF THE BAR ARE REQUIRED.
 2. PILES SHALL BE MIN. 12" (U.O.N.) CONC. FILLED CLOSED-END PIPE FRICTION PILES WITH A MINIMUM CAPACITY OF 100 TONS.

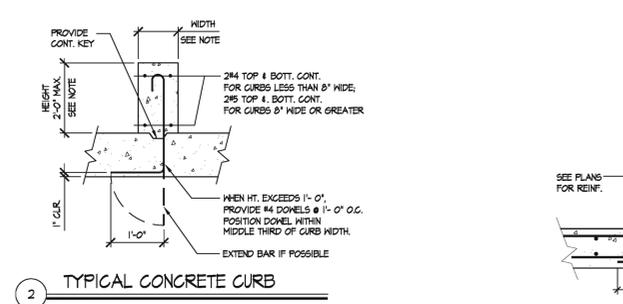


TYPICAL CONCRETE CURB
 3/4" = 1'-0"
 NOTE: FOR CURB HEIGHT, WIDTH & LOCATIONS SEE ARCH. DWGS.

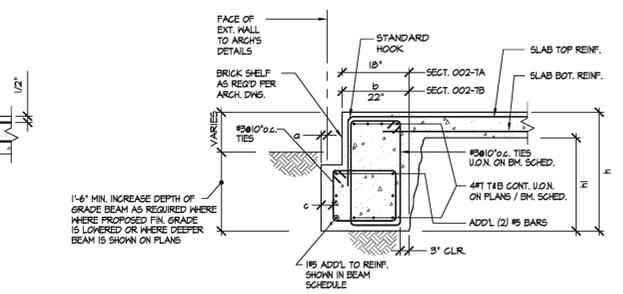


TYPICAL EXTERIOR GRADE BEAM W/ FRAMED SLAB
 1/2" = 1'-0"

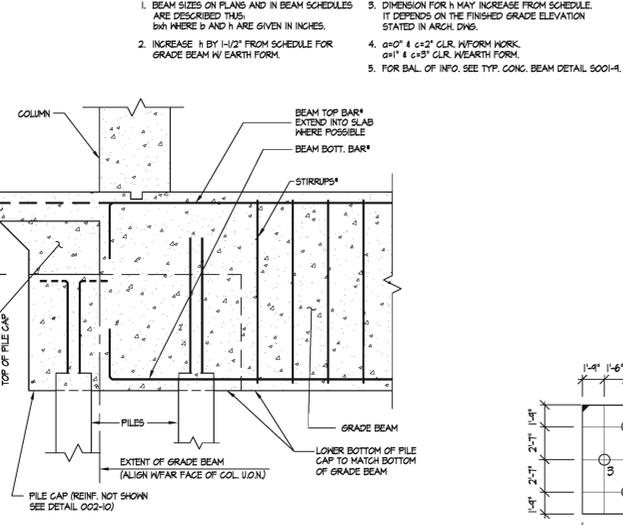


TYPICAL SECTION THRU CRASH BARRIER AT RAMP
 3/4" = 1'-0"

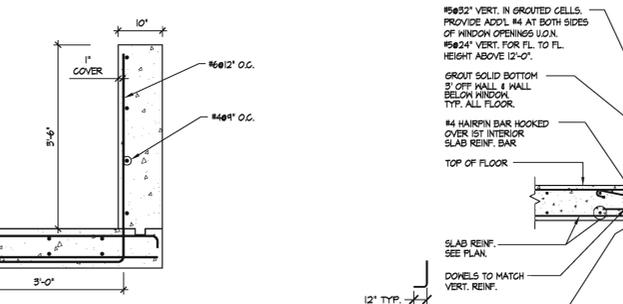


TYPICAL DETAIL AT EDGE OF SLAB
 3/4" = 1'-0"

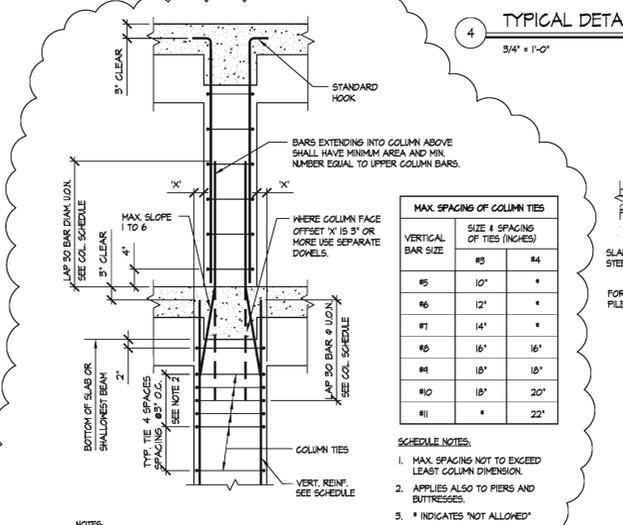


COLUMN SPLICE DETAIL
 3/4" = 1'-0"

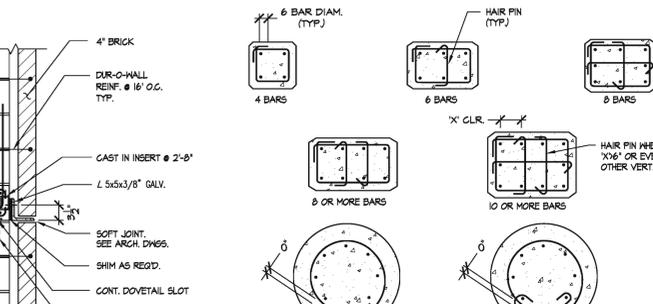


TYPICAL DETAILS AT TIED COLUMNS
 1/2" = 1'-0"

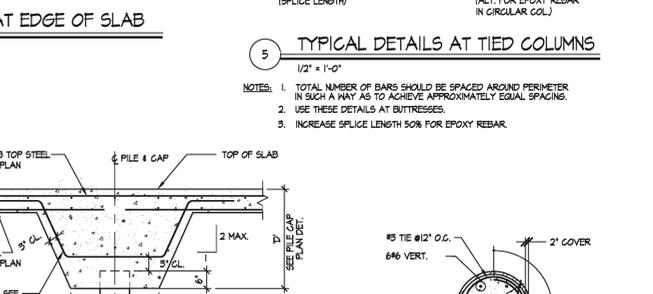

TYPICAL 16" Ø PILE SECTION
 1" = 1'-0"

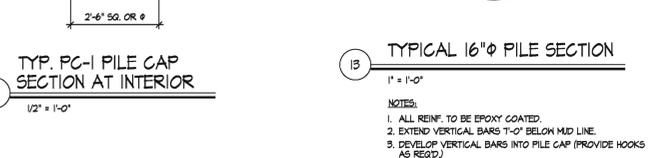

TYP. PC-1 PILE CAP SECTION AT INTERIOR
 1/2" = 1'-0"

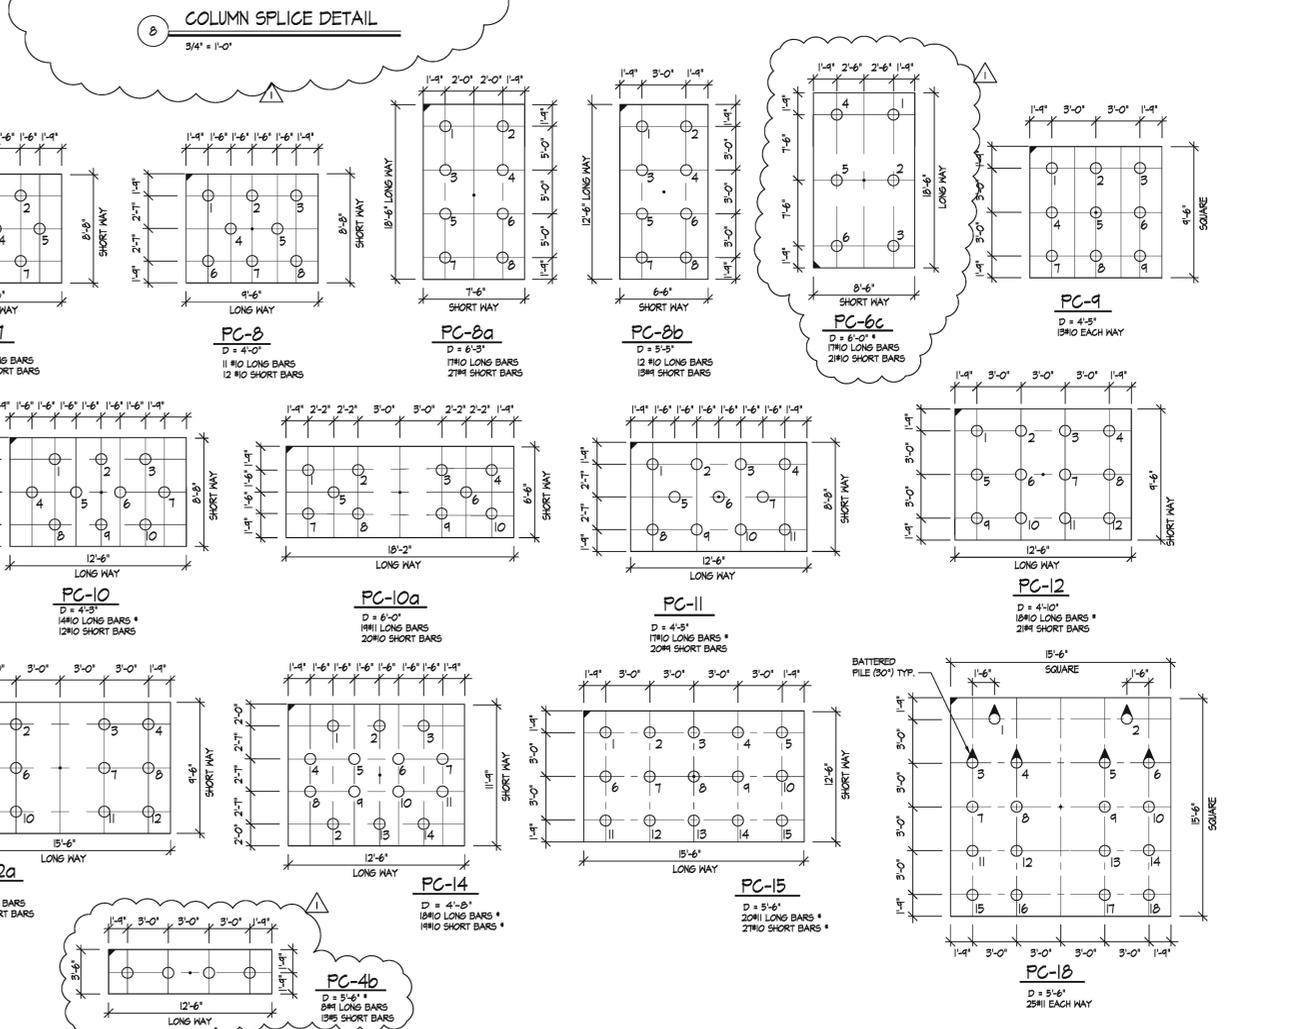

PILE CAP DETAILS
 NOTES:
 1. * INDICATES THAT NO 180 DEGREE HOOKS AT EACH END OF THE BAR ARE REQUIRED.
 2. PILES SHALL BE MIN. 12" (U.O.N.) CONC. FILLED CLOSED-END PIPE FRICTION PILES WITH A MINIMUM CAPACITY OF 100 TONS.


| | |
|------|------------|
| 10 | |
| 09 | |
| 08 | |
| 07 | |
| 06 | |
| 05 | |
| 04 | |
| 03 | |
| 02 | 08/21/2004 |
| 01 | 08/01/2004 |
| DATE | REVISION |

SOVEREIGN
 HOBOKEN, NEW JERSEY


THE APPLIED DEVELOPMENT COMPANY
 HOBOKEN, NEW JERSEY

D&W TISHMAN ARCHITECTS LLP
 770 Lexington Avenue 18th Fl
 New York, NY 10017
 Tel: 212 512 6000
 Fax: 212 512 6101



GOLDSTEIN ASSOCIATES PLLC
 consulting engineers
 31 WEST 27TH STREET
 NEW YORK, NY 10001
 TEL: 212 546 7878
 FAX: 212 546 9222

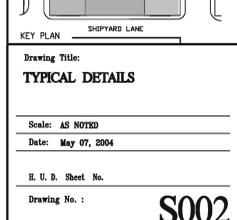


Drawing Title:
TYPICAL DETAILS
 Scale: AS NOTED
 Date: May 07, 2004
 II. U. B. Sheet No.
 Drawing No.: **S002**

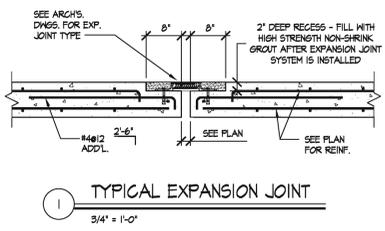


1 TYPICAL EXPANSION JOINT
3/4" = 1'-0"

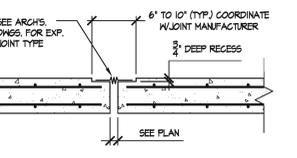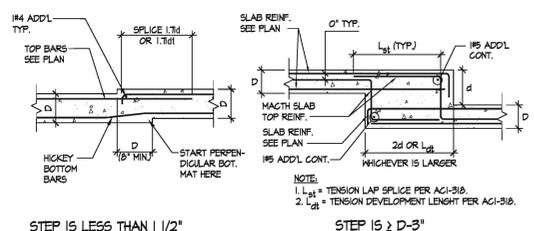

**2 TYPICAL EXPANSION JOINT
DETAIL AT PARKING LEVEL SLABS**
3/4" = 1'-0"


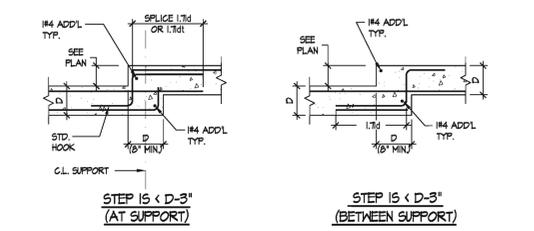


3 TYPICAL DETAILS OF STEP IN SLAB
1/2" = 1'-0"
NOTE: ALL SPLICE LENGTHS TO BE TENSION SPLICES PER ACI-318.

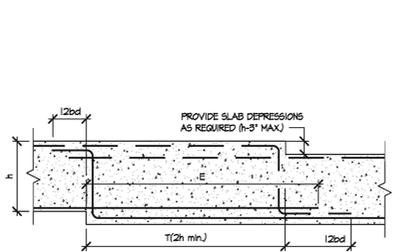


| BAR # | T |
|-------|-------|
| 4 | 1'-0" |
| 5 | 1'-9" |
| 6 | 1'-6" |
| 7 | 1'-4" |
| 8 | 2'-0" |
| 9 | 2'-3" |
| 10 | 2'-6" |
| 11 | 2'-6" |


4 TYPICAL DETAIL AT DEPRESSED SLAB
3/4" = 1'-0"
E = EMBEDMENT LENGTH PER ACI-318
bd = BAR DIAMETER
DETAILER NOTE: PROVIDE FULL ANCHORAGE OF TOP BARS AS SHOWN DASHED WHEREVER EDGE OF DEPRESSION IS LOCATED IN A CANTILEVER OR 1/8" CLEAR SPAN OR LESS FROM A CONTINUOUS END SUPPORT.

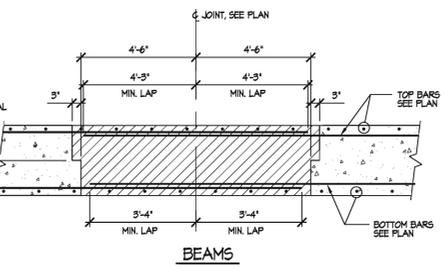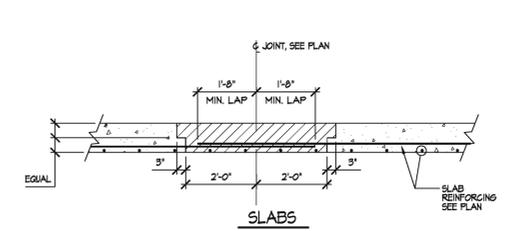


5 TYPICAL FOUR STRIP DETAILS
NT.S.
NOTE: HATCHED AREAS INDICATE CONCRETE TO BE CAST 28 DAYS AFTER LAST ADJACENT SECTION HAS BEEN CAST. ADEQUATE SUPPORTS SHALL BE PROVIDED FOR SLABS AND BEAMS ADJACENT TO THE SHRINKAGE JOINT UNTIL THE WHOLE BAY IS CAST AND ATTAINS 75% OF ITS DESIGN STRENGTH.

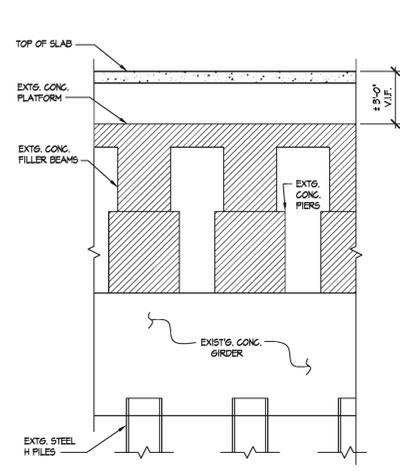


6 TYPICAL SECTION THROUGH EXISTING PIER CONSTRUCTION
NT.S.
NOTE: CONTRACTOR SHOULD ASSUME THAT THE CONCRETE PLATFORM FILLER BEAMS, PIERS WILL REQUIRE REMOVAL AT ALL NEW PILE CAP & GRADE BEAM LOCATIONS.

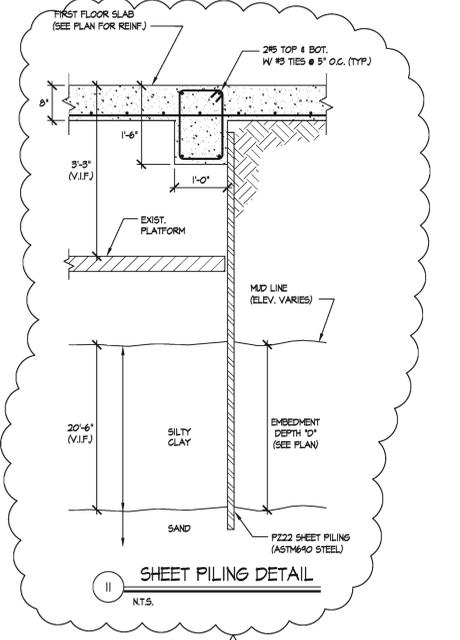




9 SHEET PILING DETAIL
NT.S.

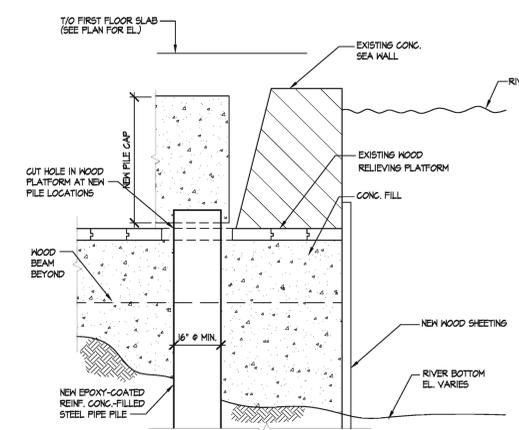



10A SECTION THROUGH RELIEVING PLATFORM AND NEW WOOD SHEETING
NT.S.
PILE INSTALLATION PROCEDURE:
1. INSTALL NEW HOOD SHEETING PER GEOTECHNICAL ENGINEER.
2. EXCAVATE AS REQ'D TO TOP OF HOOD PLATFORM.
3. CUT HOLES IN PLATFORM TO INSTALL NEW PILES.
4. WHEN PILE INSTALLATION IS COMPLETE BACKFILL BELOW PLATFORM WITH CONG. FILL.
5. BACKFILL WITH SOIL UNDER & AROUND NEW PILECAPS.

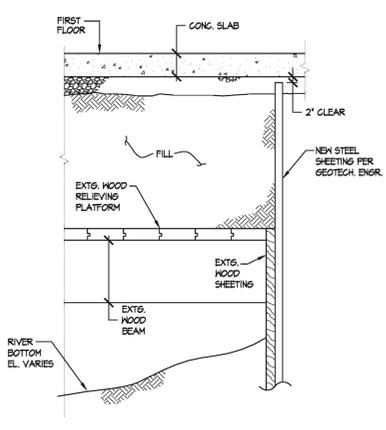


10B SECTION THROUGH RELIEVING PLATFORM AND NEW STEEL SHEETING
NT.S.
NOTE: FOR BALANCE OF INFO. SEE DETAIL S011-A.

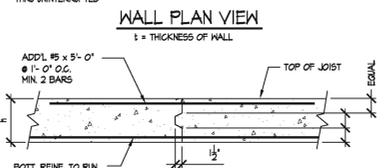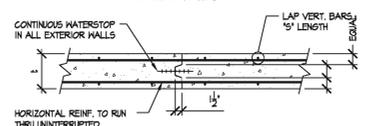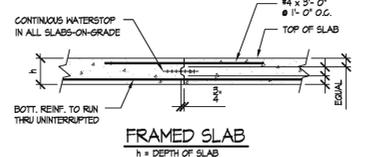


11 FRAMED SLAB
h = DEPTH OF SLAB
12 WALL PLAN VIEW
1 = THICKNESS OF WALL
13 JOIST
h = DEPTH OF JOIST

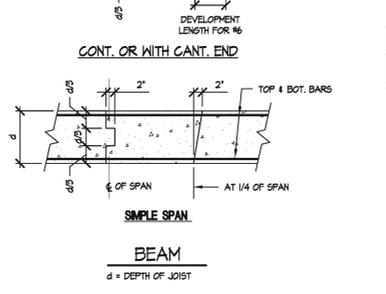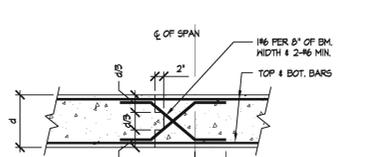


14 TYPICAL CONSTRUCTION JOINT DETAILS
3/4" = 1'-0"
NOTES:
1. CONSTRUCTION JOINTS ARE NOT ALLOWED FOR BEAMS W/ CONCENTRATED LOADS. CONSULT W/ ENGINEER FOR SPECIAL CASES.
2. CONTRACTOR SHALL SUBMIT ALL PROPOSED CONSTRUCTION JOINT FOR APPROVAL.

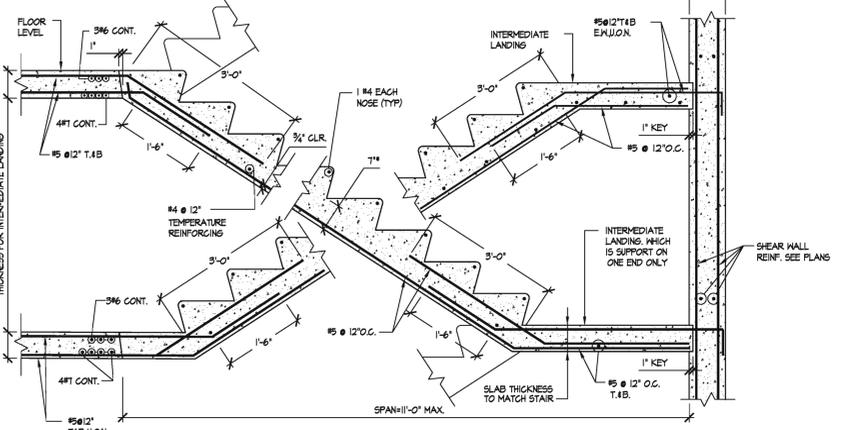


16 TYPICAL CONCRETE STAIR
3/4" = 1'-0"
NOTE: * INDICATES 8" THICK STAIR SLAB WHERE SPAN EXCEEDS 11'-0" (MAX. SPAN 12'-6")

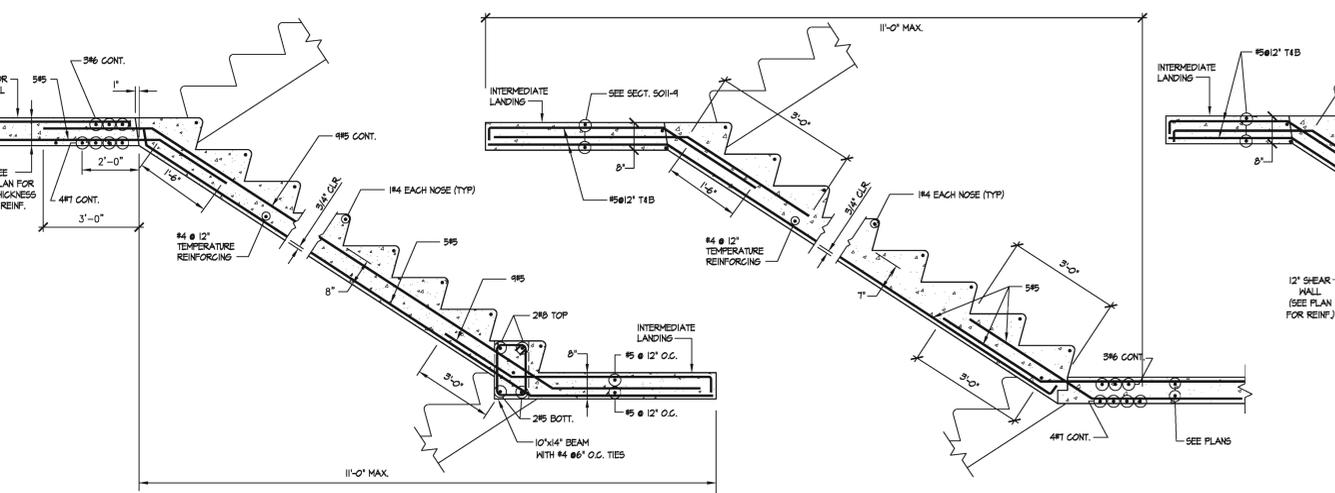

17 CONCRETE STAIR SECTION
3/4" = 1'-0"
NOTES:
1. SEE PLANS FOR LOCATIONS.
2. FOR BALANCE OF INFO. SEE DETAIL S011-B.

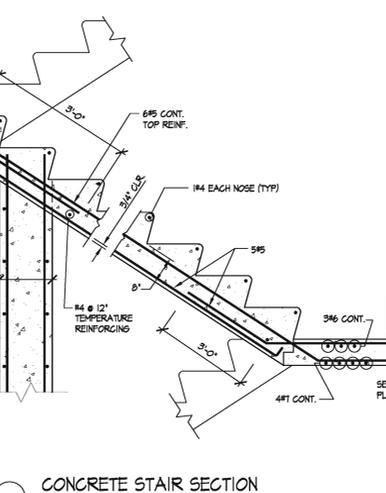

18 CONCRETE STAIR SECTION
3/4" = 1'-0"
NOTES:
1. SEE PLANS FOR LOCATIONS.
2. FOR BALANCE OF INFO. SEE DETAIL S011-B.

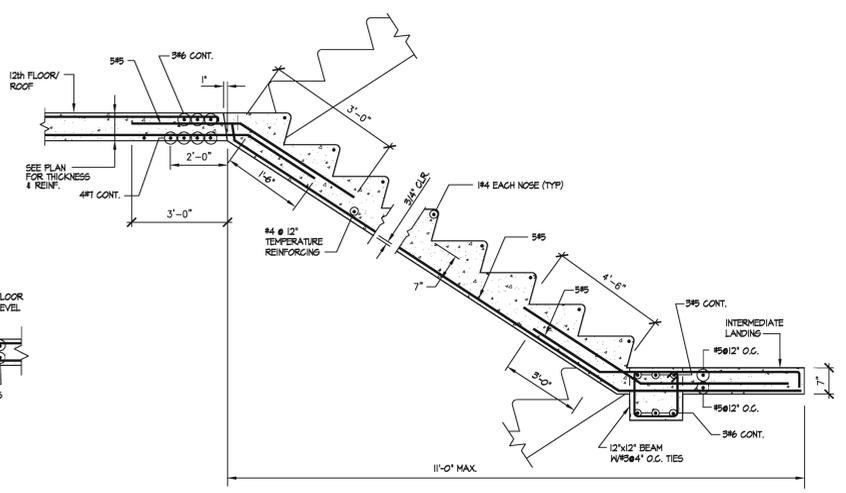


19 CONCRETE STAIR SECTION
3/4" = 1'-0"
NOTES:
1. SEE PLANS FOR LOCATIONS.
2. FOR BALANCE OF INFO. SEE DETAIL S011-B.

| NO. | DATE | REVISION |
|-----|------------|---------------------------|
| 10 | | |
| 09 | | |
| 08 | | |
| 07 | | |
| 06 | | |
| 05 | | |
| 04 | | |
| 03 | 12/01/2004 | REV. W/ SHEET PILING |
| 02 | 08/27/2004 | GENERAL SEISMIC REVISIONS |
| 01 | 08/01/2004 | ISSUED FOR BID |


SOVEREIGN
HOBOKEN, NEW JERSEY
THE APPLIED DEVELOPMENT COMPANY
HOBOKEN, NEW JERSEY

D&W TISHMAN ARCHITECTS LLP
770 Lexington Avenue 18th Fl
New York, NY 10022
Tel: 212 512 6000
Fax: 212 512 6101
N.J. Cert. 08977

GOLDSTEIN ASSOCIATES PLLC
consulting engineers
31 WEST 27TH STREET
NEW YORK, NY 10001
TEL 212 545 7878
FAX 212 545 8222

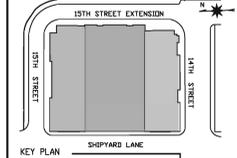

Drawing Title:
DETAILS II
Scale: AS NOTED
Date: May 07, 2004
II. U. B. Sheet No.
Drawing No.: **S011**

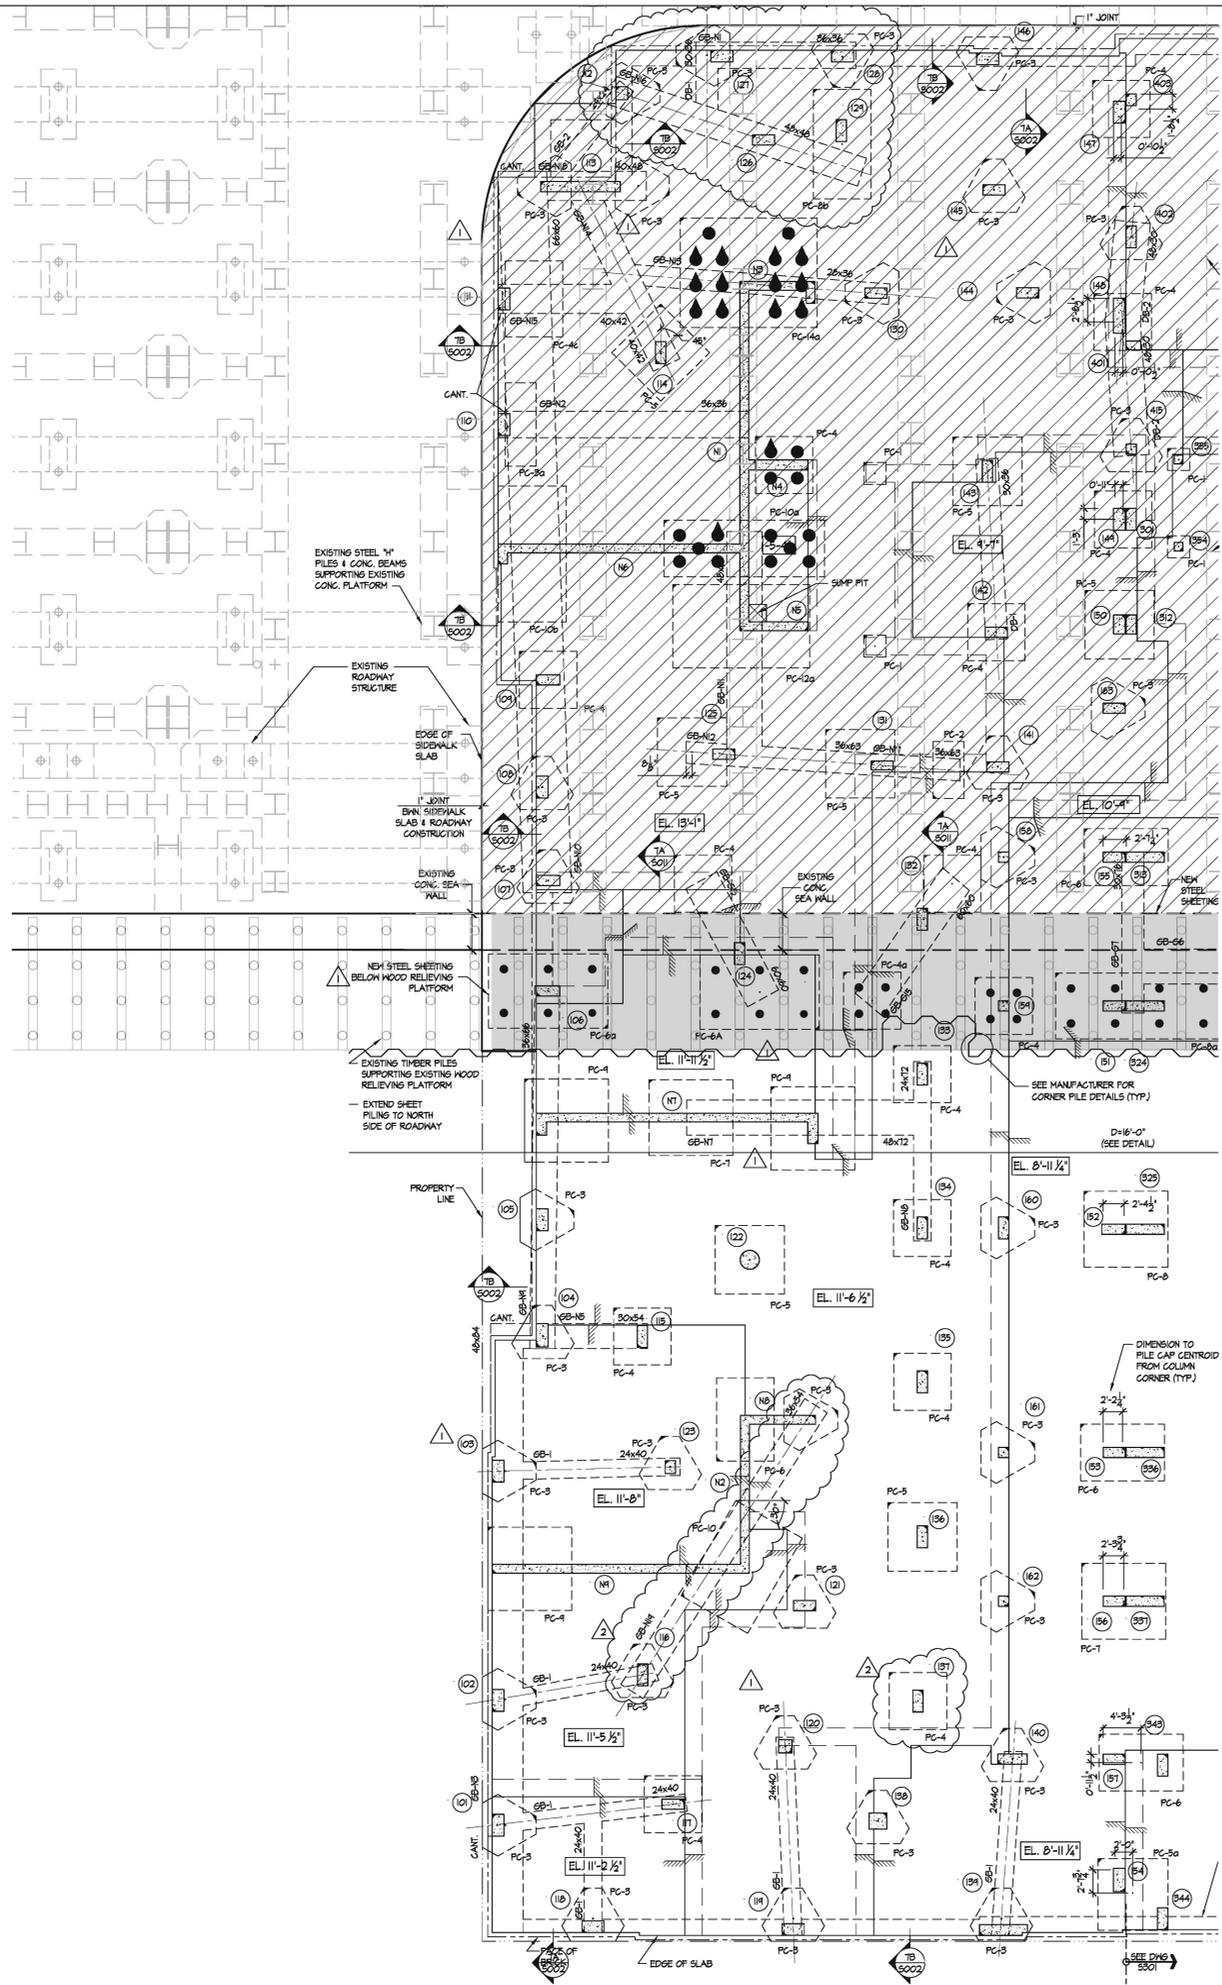

THE STRUCTURAL DRAWINGS SHALL BE USED IN CONJUNCTION WITH THE ARCH. & M.E.P. DWGS & SPECS. REFER TO ARCH. DRAWINGS FOR EDGE OF SLAB LOCATIONS.

NOTES:

- TOP OF INTERIOR PILE CAP ELEVATION TO BE (-2'-0") WITH REFERENCE TO THE FIRST FLOOR SLAB ELEVATION NOTED THIS [] U.O.N. (4-). SEE TYP. PILE CAP DETAILS ON 5002.
- TOP OF PERIMETER PILE CAP ELEVATION TO BE AS PER DETAIL 5002-7.
- FOR PILE CAP SIZE & REINF. SEE DETAIL 5002-12.
- FOR TOP OF PILE CAP ELEVATION WHERE DEEP GRADE BEAMS ARE SUPPORTED SEE DETAIL 5002-11.
- SEE FIRST FLOOR PLANS FOR SLAB REINFORCING.
- — — INDICATES CENTER LINE OF PILE CAP OR GRADE BEAM.
- CENTERLINE OF GRADE BEAM TO ALIGN WITH CENTROID OF PILE CAP & COLUMN (U.O.N.).
- FOR COLUMN SIZES & REINF. SEE COLUMN SCHEDULES ON 5003, 5004 AND 5005.
- FOR BEAM REINF. SEE GRADE BEAM SCHEDULES ON 5006A.
- ALL NEW PILES ARE 100 TON CONCRETE FILLED STEEL PIPE PILES. [] DENOTES PILES LOCATED IN AREA WITH EXISTING TIMBER PILES. V.I.F. LOCATION OF EXIST. FOUNDATION PRIOR TO DRIVING NEW PILES AS MODIFICATIONS TO NEW PILE LAYOUT (I.E. ROTATE PILE CAP) MAY BE REQUIRED TO AVOID EXISTING FOUNDATION.
- [] DENOTES PILES IN THIS AREA ARE TO BE MIN. 16" (INSIDE DIAMETER) EPOXY REINFORCED CONG. FILLED STEEL PIPE PILES. SEE DETAIL 5002-3. ALL REINF. IN PILES, PILE CAPS, AND GRADE BEAMS IN THIS AREA MUST BE EPOXY COATED.

FOUNDATION AND DIMENSIONAL PLAN
 1/1" = 1'-0"

| | | |
|-----|------------|---------------------------|
| 10 | | |
| 09 | | |
| 08 | | |
| 07 | | |
| 06 | | |
| 05 | | |
| 04 | | |
| 03 | 08/04/2005 | SK-1 THRU SK-58 REVISION |
| 02 | 08/27/2004 | GENERAL SEISMIC REVISIONS |
| 01 | 08/01/2004 | ISSUED FOR BID |
| No. | DATE | REVISION |

SOVEREIGN
 HOBOKEN, NEW JERSEY

THE APPLIED DEVELOPMENT COMPANY
 HOBOKEN, NEW JERSEY

D&W TISHMAN ARCHITECTS LLP
 770 Lexington Avenue 18th Fl
 New York, NY 10022
 Tel: 212 517 0888
 Fax: 212 517 0161

N.J. Cert. 08977

GOLDSTEIN ASSOCIATES PLLC
 consulting engineers
 31 WEST 27TH STREET
 NEW YORK, NY 10001
 TEL 212 545 7878
 FAX 212 545 8222

KEY PLAN

Drawing Title:
NORTH TOWER FOUNDATION AND DIMENSIONAL PLAN


Scale: AS NOTED

Date: May 07, 2004

H. U. D. Sheet No.

Drawing No. :

S100

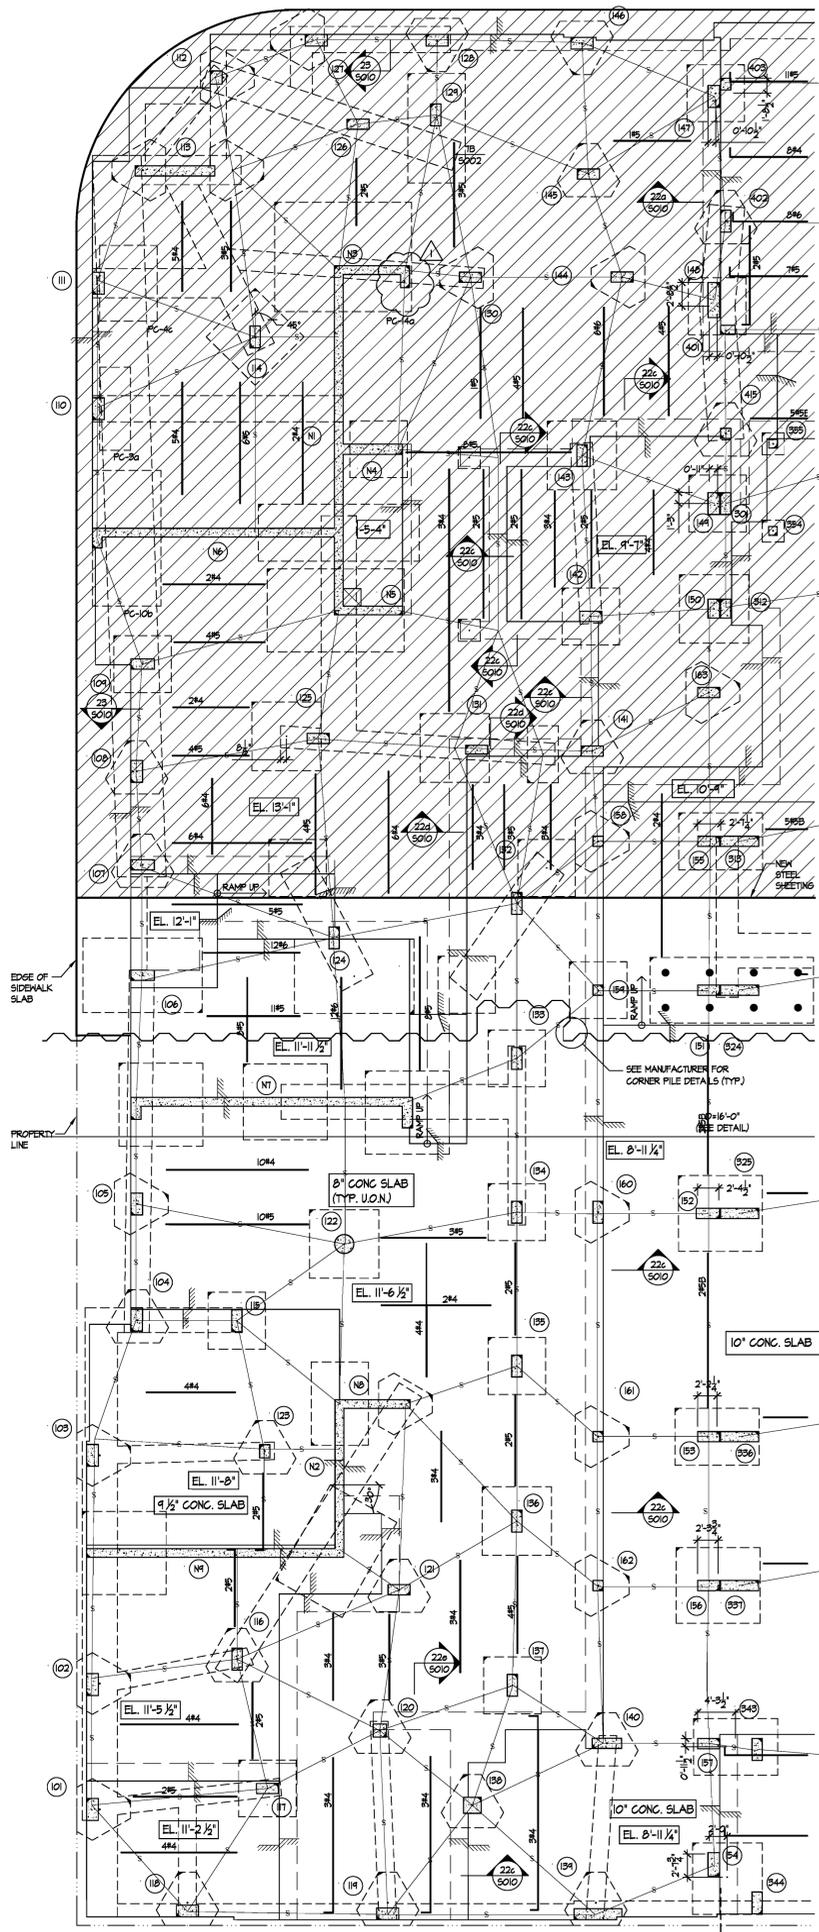


1 ADDITIONAL BOTTOM REINFORCING & DIMENSIONAL PLAN
1/8" = 1'-0"

THE STRUCTURAL DRAWINGS SHALL BE USED IN CONJUNCTION WITH THE ARCH. & M.E.P. DWGS & SPECS. REFER TO ARCH. DRAWINGS FOR EDGE OF SLAB LOCATIONS.

NOTES:

1. FOR FOUNDATION & GRADE BEAM INFORMATION SEE FOUNDATION PLANS.
2. TYP. BOTTOM REINFORCING - #4 @ 12" O.C. EACH WAY CONTINUOUS (U.O.N.), #5 @ 12" O.C. EACH WAY CONTINUOUS IN 10' CONC. SLAB. SEE TYP. FLAT SLAB DETAILS ON S001.
3. PLACE NORTH - SOUTH REINFORCING IN THE OUTER - MOST LAYERS.
4. FOR COLUMN & MIDDLE STRIPS SEE TYPICAL FLAT SLAB DETAIL ON S001.
5. FOR COLUMN COORDINATES SEE FOUNDATION PLANS.
6. FOR COLUMN SIZES & REINF. SEE COLUMN SCHEDULES ON S003, S004 AND S005.
7. FOR BEAM REINF. SEE BEAM SCHEDULES ON S006A.
8. TOP OF SLAB ELEVATION SHOWN THIS []
9. ALL REINF. IN BALCONIES, TERRACES & OTHER AREAS OF EXPOSED CONCRETE TO BE EPOXY COATED.
10. ALL TERRACES MUST BE PITCHED TO DRAIN WITH STRUCTURAL CONCRETE. SEE ARCH. DWGS. FOR PITCHES & LOCATIONS OF DRAINS. 8" SLAB MIN. REQUIRED.
11. SEE S011 FOR SLAB STEP DETAILS.
12. SEE TYP. STAIR DETAILS ON S011 FOR ADDL. REINF. REQ'D. IN SLAB.
13. [] INDICATES ALL BOTTOM REINF. TO BE EPOXY COATED IN THIS AREA.
14. SEE TYP. DETAIL S011-3 FOR STEP IN SLAB AT TERRAZZO FLOOR. SEE ARCH. FOR LOCATIONS.

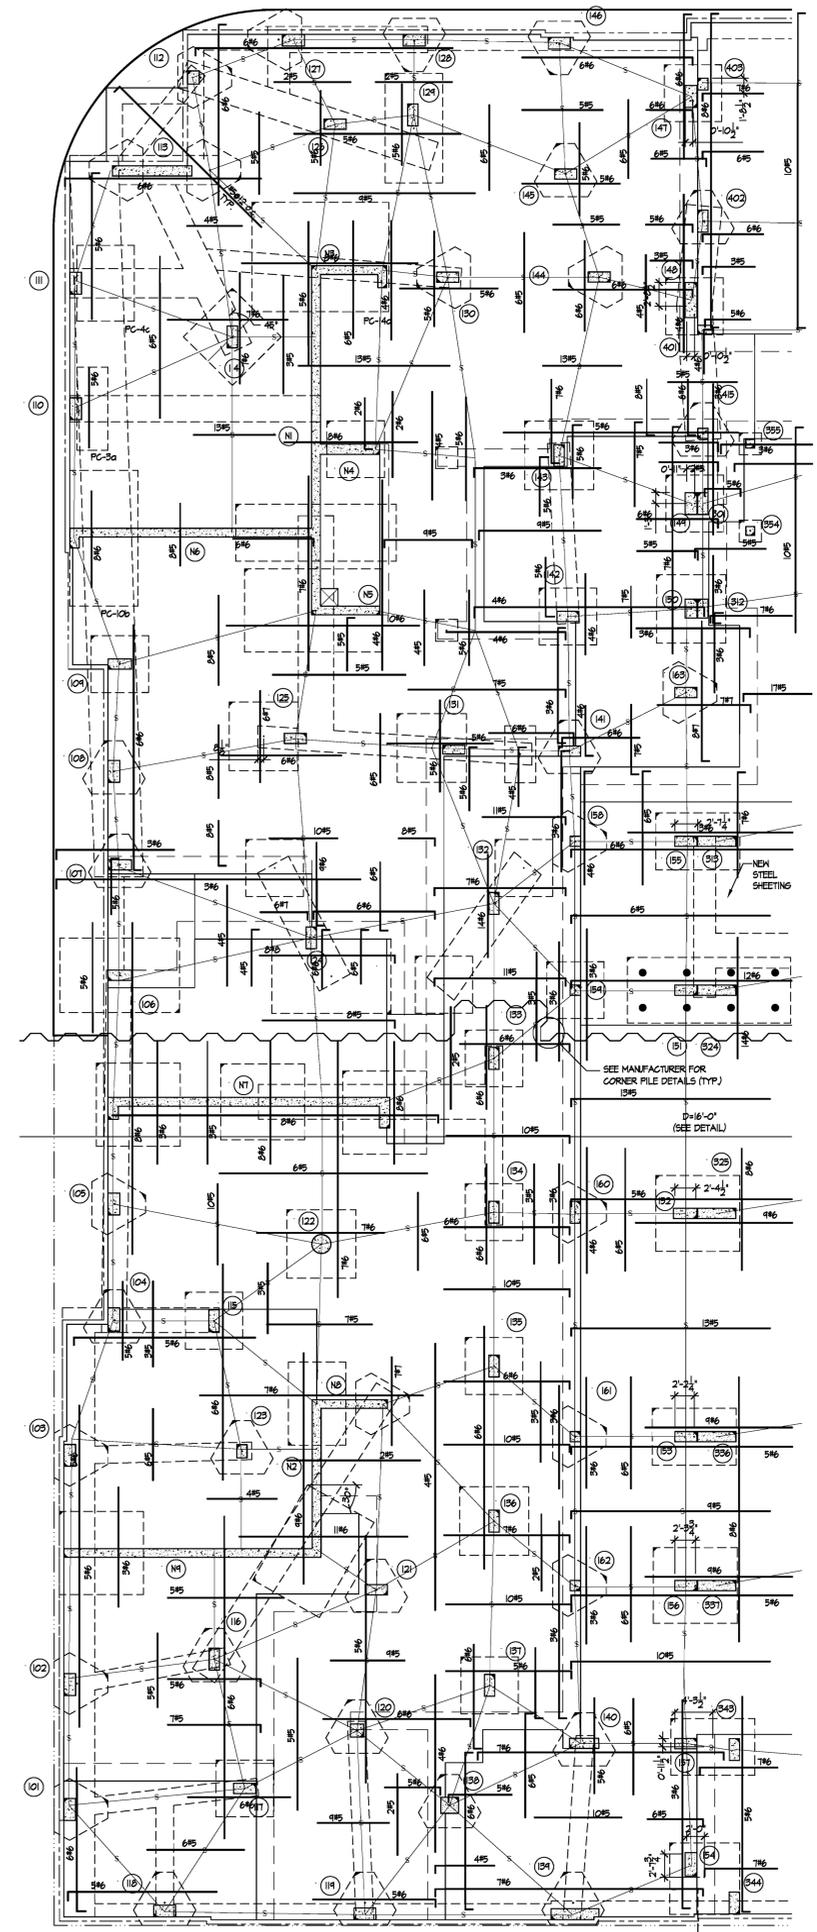

2 TOP REINFORCING ONLY
1/8" = 1'-0"

| | | |
|-----|------------|---------------------------|
| 10 | | |
| 09 | | |
| 08 | | |
| 07 | | |
| 06 | | |
| 05 | | |
| 04 | | |
| 03 | | |
| 02 | 08/21/2004 | GENERAL SEISMIC REVISIONS |
| 01 | 05/01/2004 | ISSUED FOR BID |
| No. | DATE | REVISION |

SOVEREIGN
ROBOKEN, NEW JERSEY

THE APPLIED DEVELOPMENT COMPANY
ROBOKEN, NEW JERSEY

D&W TISHMAN ARCHITECTS LLP
770 Lexington Avenue 18th Fl
New York, NY 10017
Tel: 212 517 0088
Fax: 212 517 0101


N.J. Cert. 069377

GOLDSTEIN ASSOCIATES PLLC
consulting engineers
31 WEST 27TH STREET
NEW YORK, NY 10001
TEL: 212 545 7878
FAX: 212 545 8222

KEY PLAN
Drawing Title:
**NORTH TOWER
FIRST FLOOR
FRAMING PLANS**
Scale: AS NOTED
Date: May 07, 2004

H. U. S. Sheet No.
Drawing No.:

S101

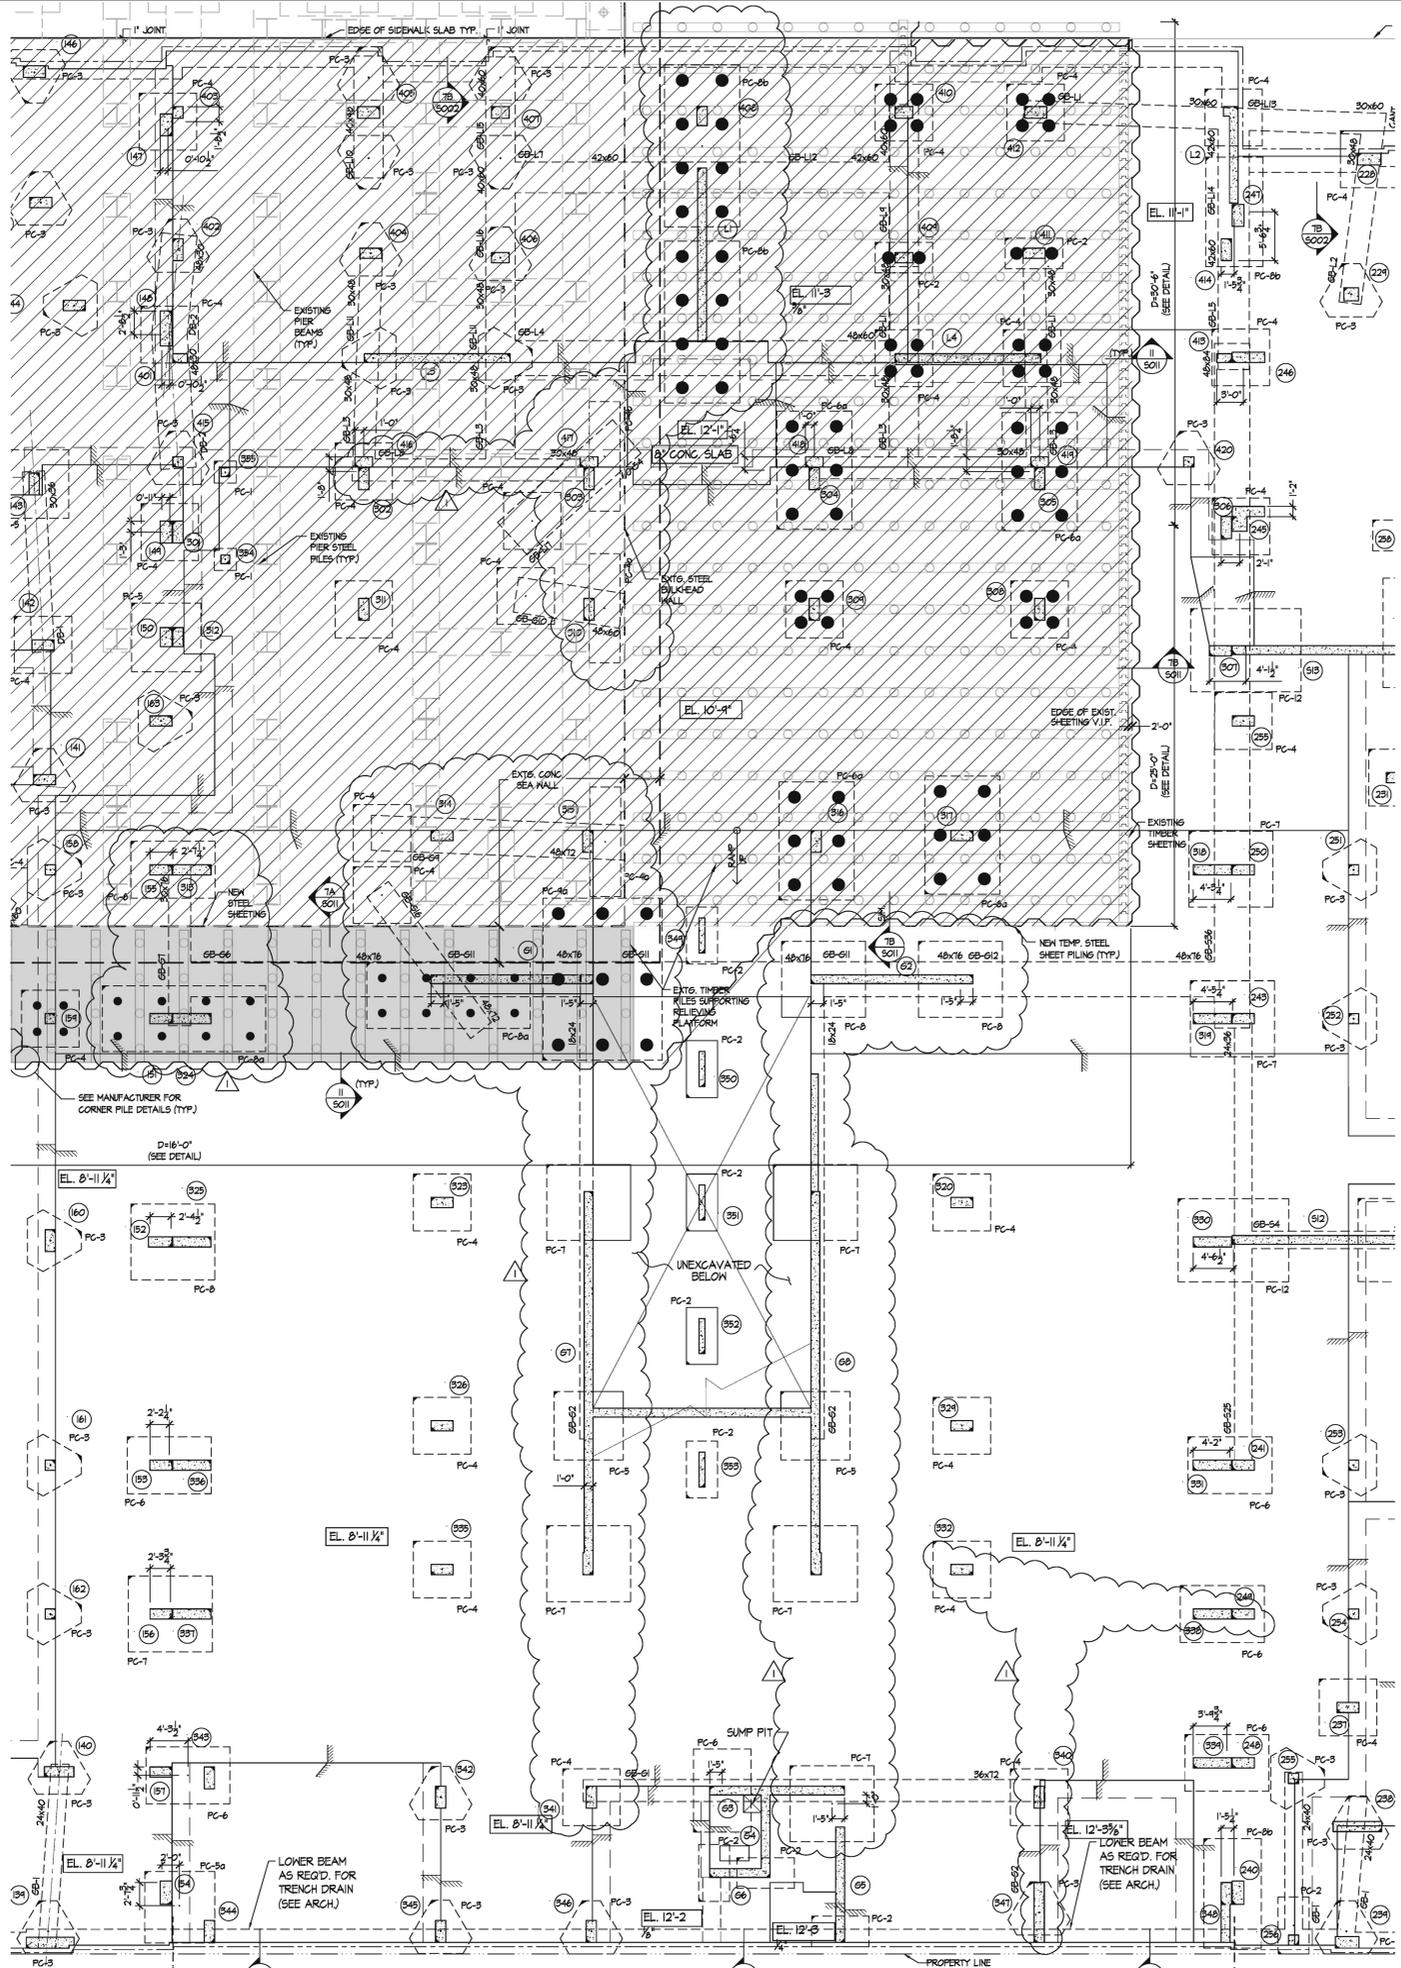

FOUNDATION AND DIMENSIONAL PLAN
1/8" = 1'-0"

THE STRUCTURAL DRAWINGS SHALL BE USED IN CONJUNCTION WITH THE ARCH. & M.E.P. DWGS & SPECS. REFER TO ARCH. DRAWINGS FOR EDGE OF SLAB LOCATIONS.

- NOTES:
- TOP OF INTERIOR PILE CAP ELEVATION TO BE (-2'-0") WITH REFERENCE TO THE FIRST FLOOR SLAB ELEVATION NOTED THIS ELEV. (U.G.N. (2...)). SEE TYP. PILE CAP DETAIL ON 5002-1.
 - TOP OF PERIMETER PILE CAP ELEVATION TO BE AS PER DETAIL 5002-1.
 - FOR PILE CAP SIZE & REINF. SEE DETAIL 5002-12.
 - FOR TOP OF PILE CAP ELEVATION WHERE DEEP GRADE BEAMS ARE SUPPORTED SEE DETAIL 5002-11.
 - SEE FIRST FLOOR PLANS FOR SLAB REINFORCING.
 - INDICATES CENTER LINE OF PILE CAP OR GRADE BEAM.
 - CENTERLINE OF GRADE BEAM TO ALIGN WITH CENTROID OF PILE CAP & COLUMN (U.G.N.).
 - FOR COLUMN SIZES & REINF. SEE COLUMN SCHEDULES ON 5003, 5004 AND 5005.
 - FOR BEAM REINF. SEE GRADE BEAM SCHEDULES ON 5006A.
 - DENOTES AREA BELOW EXTS. HOOD RELIEVING PLATFORM TO BE FILLED WITH CONCRETE FILL AFTER PILES ARE DRIVEN SEE DETAIL 5011-7A. ALL REINF. IN PILES, PILE CAPS, AND GRADE BEAMS IN THIS AREA MUST BE EPOXY COATED.
 - DENOTES PILES LOCATED IN AREA WITH EXISTING TIMBER PILES. V.I.F. LOCATION OF EXTS. FOUNDATION PRIOR TO DRIVING NEW PILES AS MODIFICATIONS TO NEW PILE LAYOUT (I.E. ROTATE PILE CAP) MAY BE REQUIRED TO AVOID EXTS. FOUNDATION.
 - ▨ DENOTES PILES IN THIS AREA TO BE MIN. 16" (INSIDE DIAMETER) REINFORCED CONC. FILLED STEEL PIPE PILES. SEE DETAIL 5002-13. ALL REINF. IN PILES, PILE CAPS, AND GRADE BEAMS IN THIS AREA MUST BE EPOXY COATED.

| | | |
|-----|------------|---------------------------|
| 10 | | |
| 09 | | |
| 08 | | |
| 07 | | |
| 06 | | |
| 05 | | |
| 04 | | |
| 03 | | |
| 02 | 08/27/2004 | GENERAL SEISMIC REVISIONS |
| 01 | 05/07/2004 | ISSUED FOR BID |
| No. | DATE | REVISION |

SOVEREIGN
HOBOKEN, NEW JERSEY

THE APPLIED DEVELOPMENT COMPANY
HOBOKEN, NEW JERSEY

D&W TISHMAN ARCHITECTS LLP
770 Lexington Avenue 18th Fl
New York, NY 10021
Tel: 212 517 0888
Fax: 212 517 0501

N.J. Cert. 08937

GOLDSTEIN ASSOCIATES PLLC
consulting engineers
31 WEST 27TH STREET
NEW YORK, NY 10001
TEL 212 545 7878
FAX 212 545 8222


KEY PLAN

Drawing Title:
GARAGE & TOWNHOUSE FOUNDATION AND DIMENSIONAL PLAN


Scale: AS NOTED

Date: May 07, 2004

H. U. B. Sheet No.
Drawing No. : **S300**

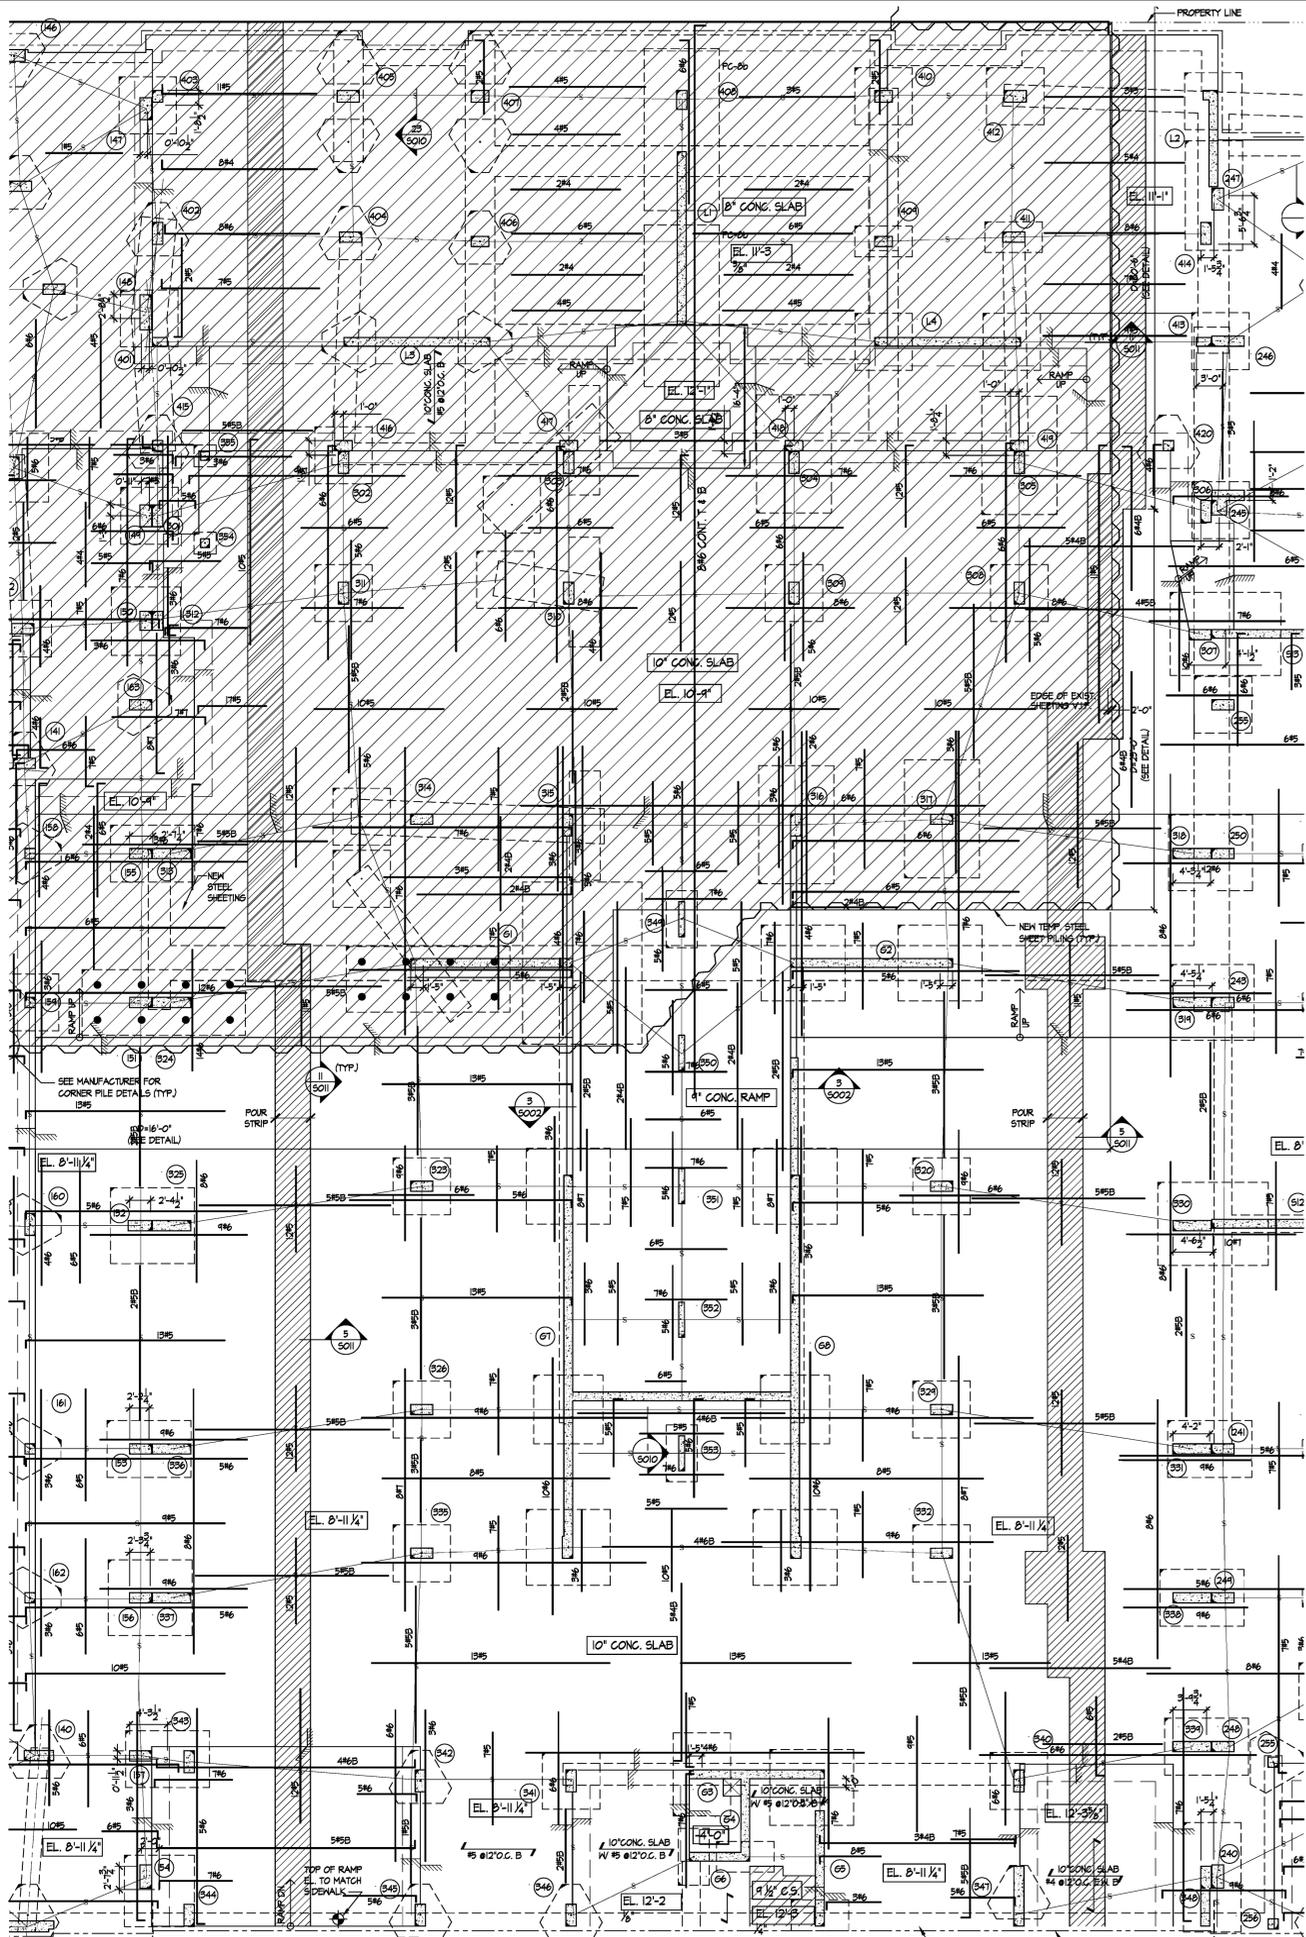

1 GARAGE REINFORCING AND DIMENSIONAL PLAN
TOWNHOUSE ADDITIONAL BOTTOM REINFORCING AND DIMENSIONAL PLAN
1/8" = 1'-0"

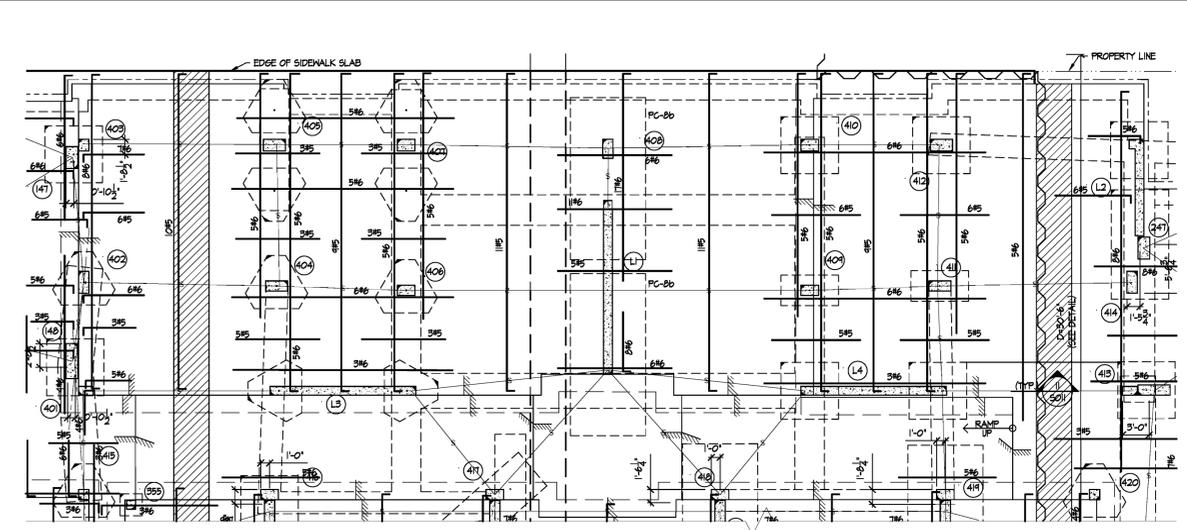

2 TOWNHOUSE TOP REINFORCING ONLY
1/8" = 1'-0"

THE STRUCTURAL DRAWINGS SHALL BE USED IN CONJUNCTION WITH THE ARCH. & M.E.P. DWGS & SPECS. REFER TO ARCH. DRAWINGS FOR EDGE OF SLAB LOCATIONS.

- NOTES:
- FOR FOUNDATION & GRADE BEAM INFORMATION SEE FOUNDATION PLANS.
 - TYP. BOTTOM REINFORCING - #5 @ 12" O.C. EACH WAY CONTINUOUS IN 10" SLAB (U.O.N.)
- #4 @ 12" O.C. EACH WAY CONTINUOUS IN 8" & 4" SLAB (U.O.N.)
SEE TYP. FLAT SLAB DETAILS ON S001.
 - PLACE NORTH - SOUTH REINFORCING IN THE OUTER - MOST LAYER.
 - FOR COLUMN & MIDDLE STRIPS SEE TYPICAL FLAT SLAB DETAIL ON S001.
 - FOR COLUMN COORDINATES SEE FOUNDATION PLANS.
 - FOR COLUMN SIZES & REINF. SEE COLUMN SCHEDULES ON S003, S004 AND S005.
 - FOR BEAM REINF. SEE GRADE BEAM SCHEDULES ON S006A.
 - TOP OF SLAB ELEVATION SHOWN THIS []
 - COORDINATE SLAB PENETRATIONS W/ PLUMBING, MECHANICAL, ELECTRICAL & SPRINKLER DWGS.
 - ↖ DENOTES ONE-WAY SLAB. SEE DETAIL S001-H.
 - B DENOTES ADDITIONAL BOTTOM REINF. IN GARAGE AREA.
 - REINF. AT BASE OF RAMP TO BE EMBEDDED INTO FIRST FLOOR SLAB.
 - SEE TYPICAL STAIR DETAILS ON S011 FOR ADDL. REINF. REQ'D. IN SLAB.
 - [] INDICATES BOTTOM REINF. TO BE EPOXY COATED IN THIS AREA.
 - SEE TYP. DETAIL S011-3 FOR STEP IN SLAB AT TERRAZZO FLOOR. SEE ARCH. FOR LOCATIONS.

| | | |
|-----|------------|---------------------------|
| 10 | | |
| 09 | | |
| 08 | | |
| 07 | | |
| 06 | | |
| 05 | | |
| 04 | | |
| 03 | | |
| 02 | 08/27/2004 | GENERAL SEISMIC REVISIONS |
| 01 | 05/01/2004 | ISSUED FOR BID |
| NO. | DATE | REVISION |

SOVEREIGN
HOBOKEN, NEW JERSEY

THE APPLIED DEVELOPMENT COMPANY
HOBOKEN, NEW JERSEY

D&W TISHMAN ARCHITECTS LLP
770 Lexington Avenue 18th Fl
New York, NY 10017
Tel: 212 517 0088
Fax: 212 517 0101

N.J. Cert. 089377

GOLDSTEIN ASSOCIATES PLLC
consulting engineers
31 WEST 27TH STREET
NEW YORK, NY 10001
TEL 212 546 7878
FAX 212 546 8222

KEY PLAN

Drawing Title:
**GARAGE & TOWNHOUSE
FIRST FLOOR
FRAMING PLANS**

Scale: AS NOTED

Date: May 07, 2004

H. U. D. Sheet No.
Drawing No. : **S301**